

HARTWIG  
PLUMBING &  
HEATING, INC.

28000 E. Bank Street  
Mesa, AZ 85205  
815.943.4430 Phone  
815.943.4480 Fax

JOB: P-7/08


DANIA DISTRIBUTION CENTER  
BREWSTER CREEK BLVD.  
BARTLETT, ILLINOIS

date	description
04-16-07	UNDERGROUND SANITARY
11-05-07	AS BUILT DRAWING

AS BUILT DRAWING

1-1

AS-BUILT

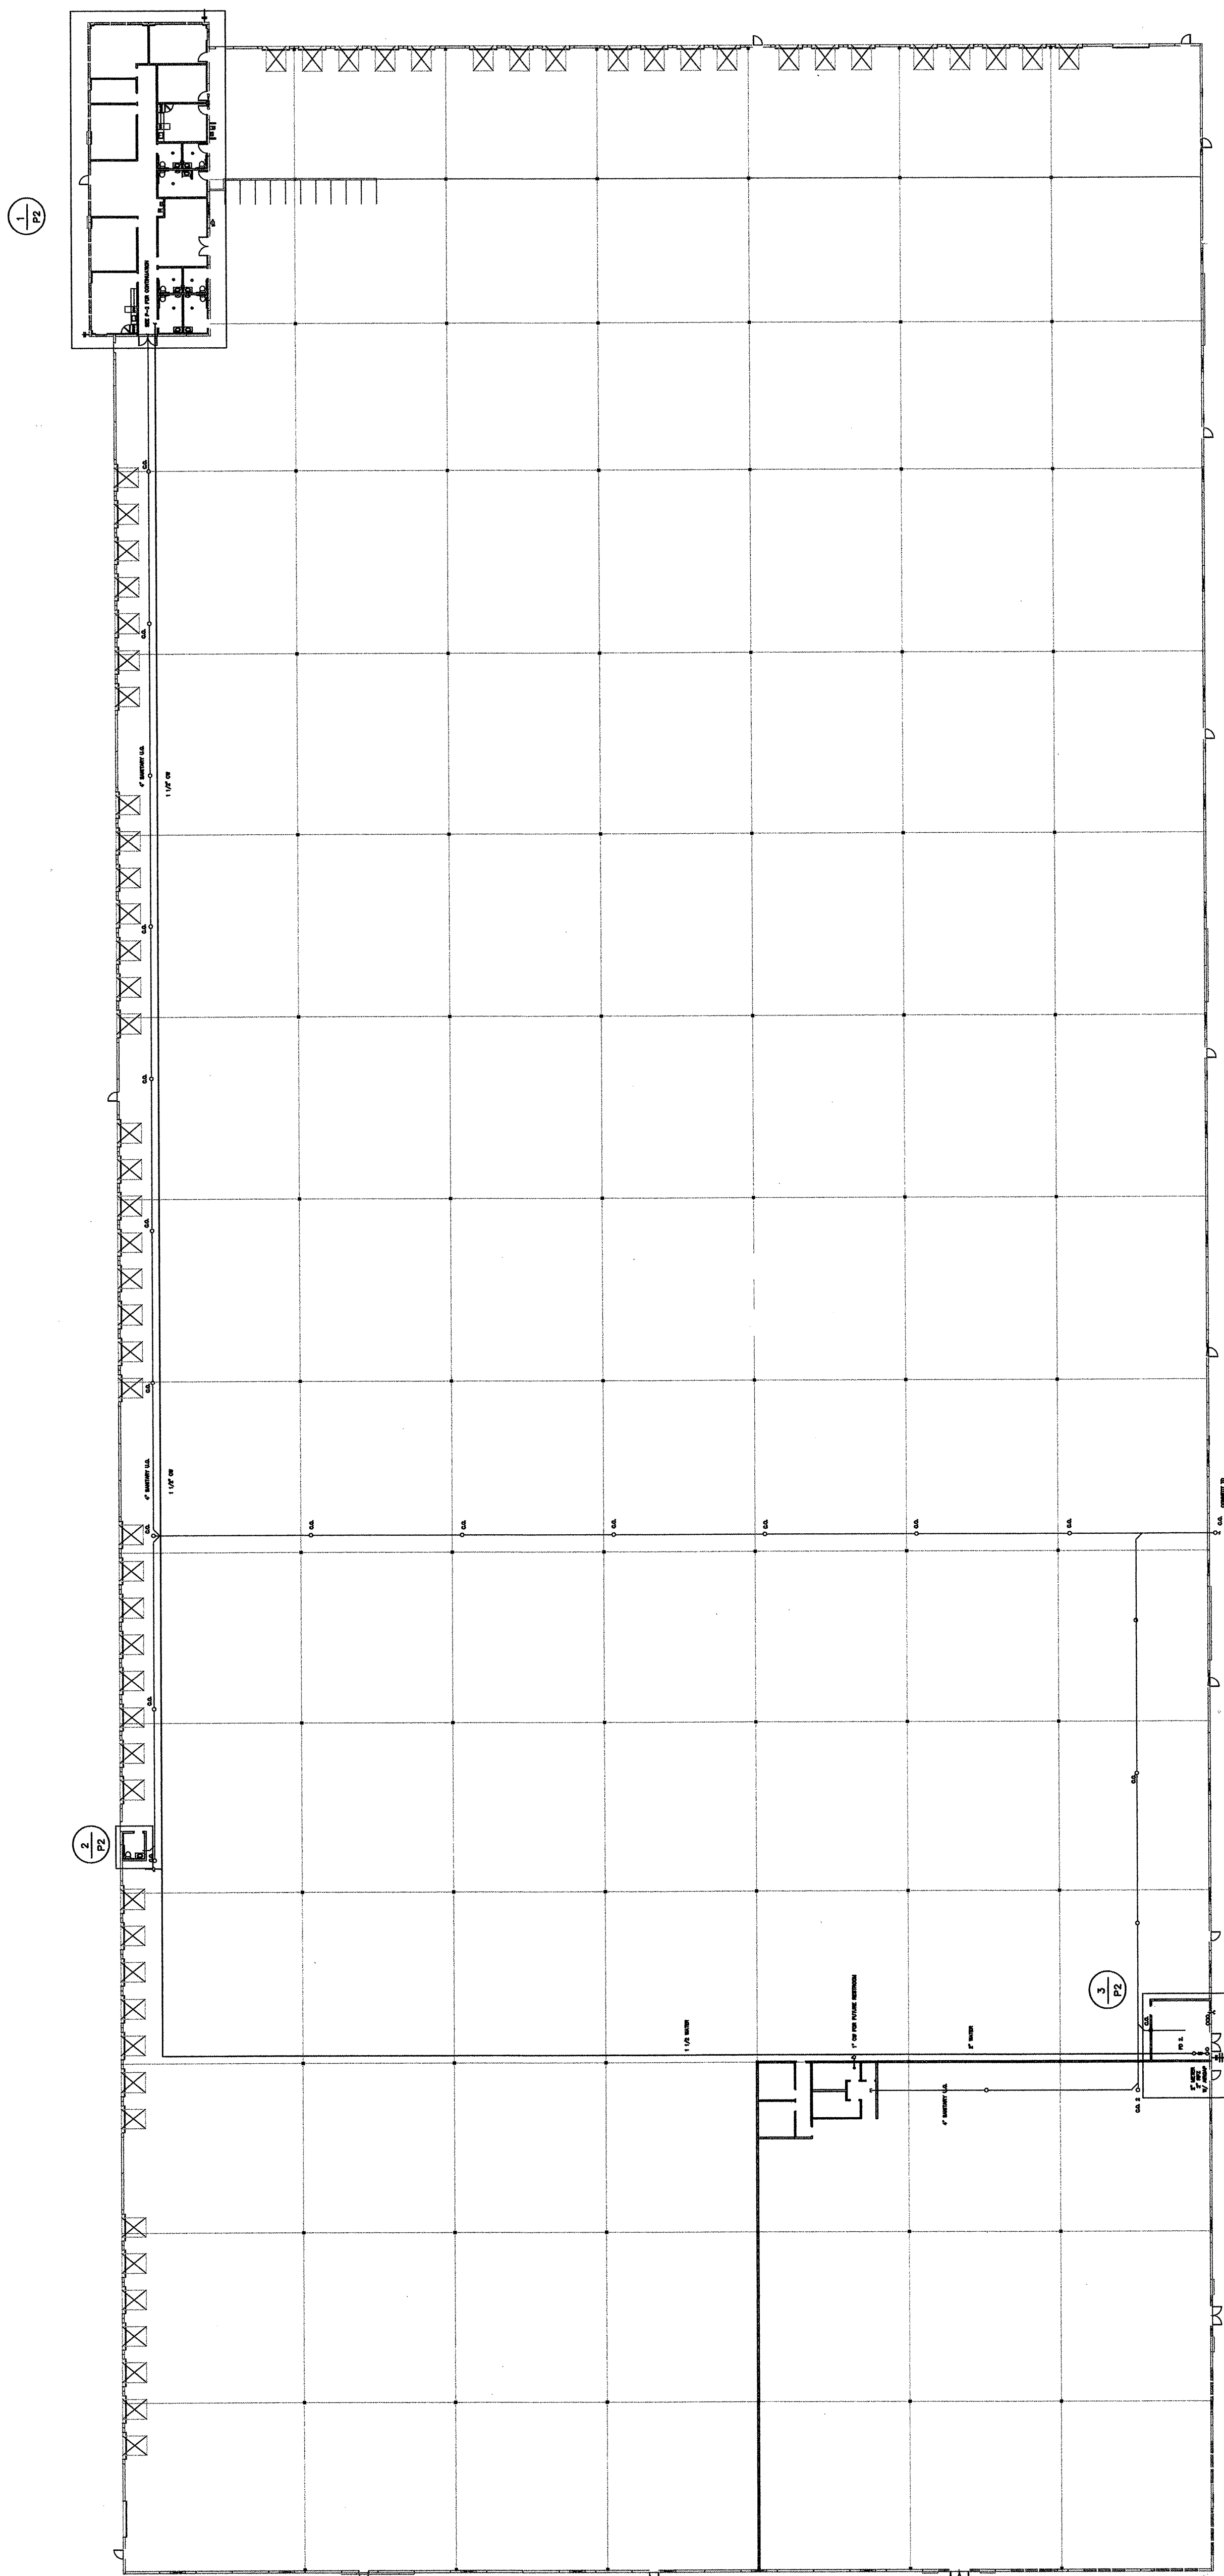

NORTH

UNDERGROUND SANITARY

SCALE: 1/32" = 1'-0"